

LOT SURVEY FOR CITIZENS SAVING TRUST

DATE 11-5-48

TOWN Marshall OHIO

No. _____

OWNER Preston & Hattery
Div of Lots # 9807, 9808, 9810

OCCUPANT _____


SUB-DIV. 9811 & 9812 of PT. OF SE QR.
Woodland Farms Sec'd

SEC. 29 TWP. 21 RN. 18

PLAT RECORDED IN VOL. 15 No. _____ PAGE 5 OF 141

SCALE 1" = 60'

Shepard Rd 60'

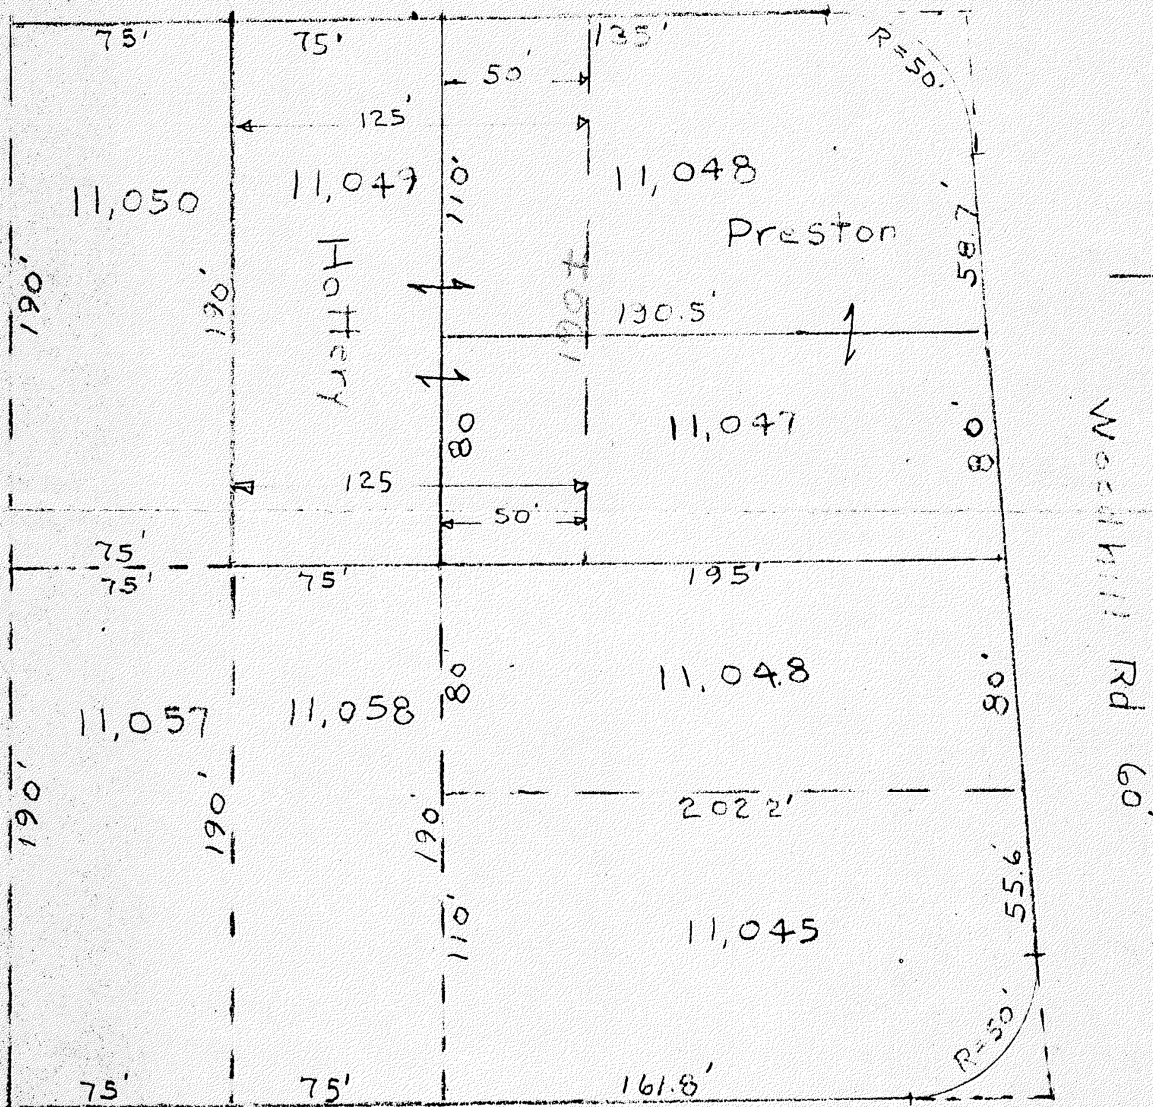

Austin Rd 60

DESCRIPTION OF ~~BUILDINGS~~ Lots

NO. 1. Hattery; West 50 feet Lots # 11,048 & 11,047 & all of Lot # 11,049
NO. 2. Preston; All of Lots # 11,048 & 11,047 save & except
~~NO. 3.~~ West 50' of Same

I HEREBY CERTIFY THAT I HAVE MADE A SURVEY OF THESE PREMISES AND FIND THE LOT SIZE, BUILDINGS, EASEMENTS, SET-BACK LINES, ETC. TO BE SHOWN.

H.C. Sword
Lic. Surv # 933

ENGINEER AND SURVEYOR, MANSFIELD, OHIO